
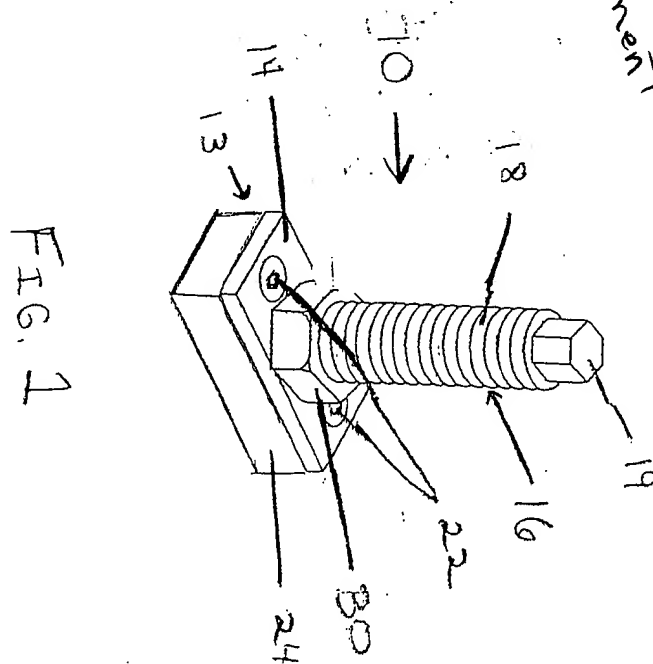


DRAWING AMENDMENTS

Please amend FIGURE 2 as shown in the "Annotated Marked-Up Drawing" attached hereto as Exhibit A, and in "Replacement Sheet No.1" of the drawings attached hereto as Exhibit B.

ANNOTATED MARKED-UP DRAWINGS EXHIBIT A

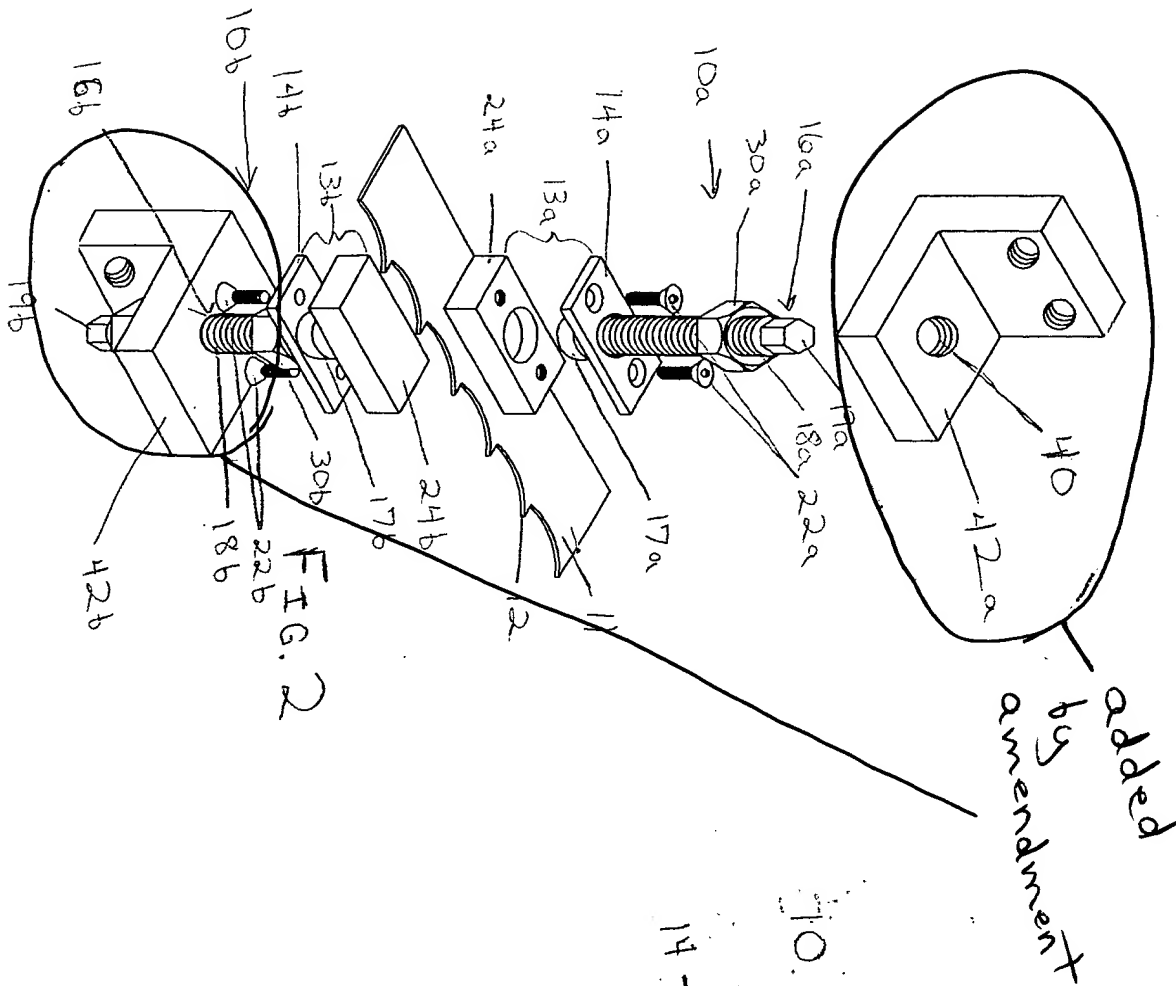

REPLACEMENT SHEET 1

EXHIBIT B

